




REV.	ME.	DESCRIPTION	BY	DATE	APPROVED
1		REVISED DWS. FOR DALL SEERDES'S FROM THE WATER MARINE MARKED UP PRINT	HN	8-14-81	

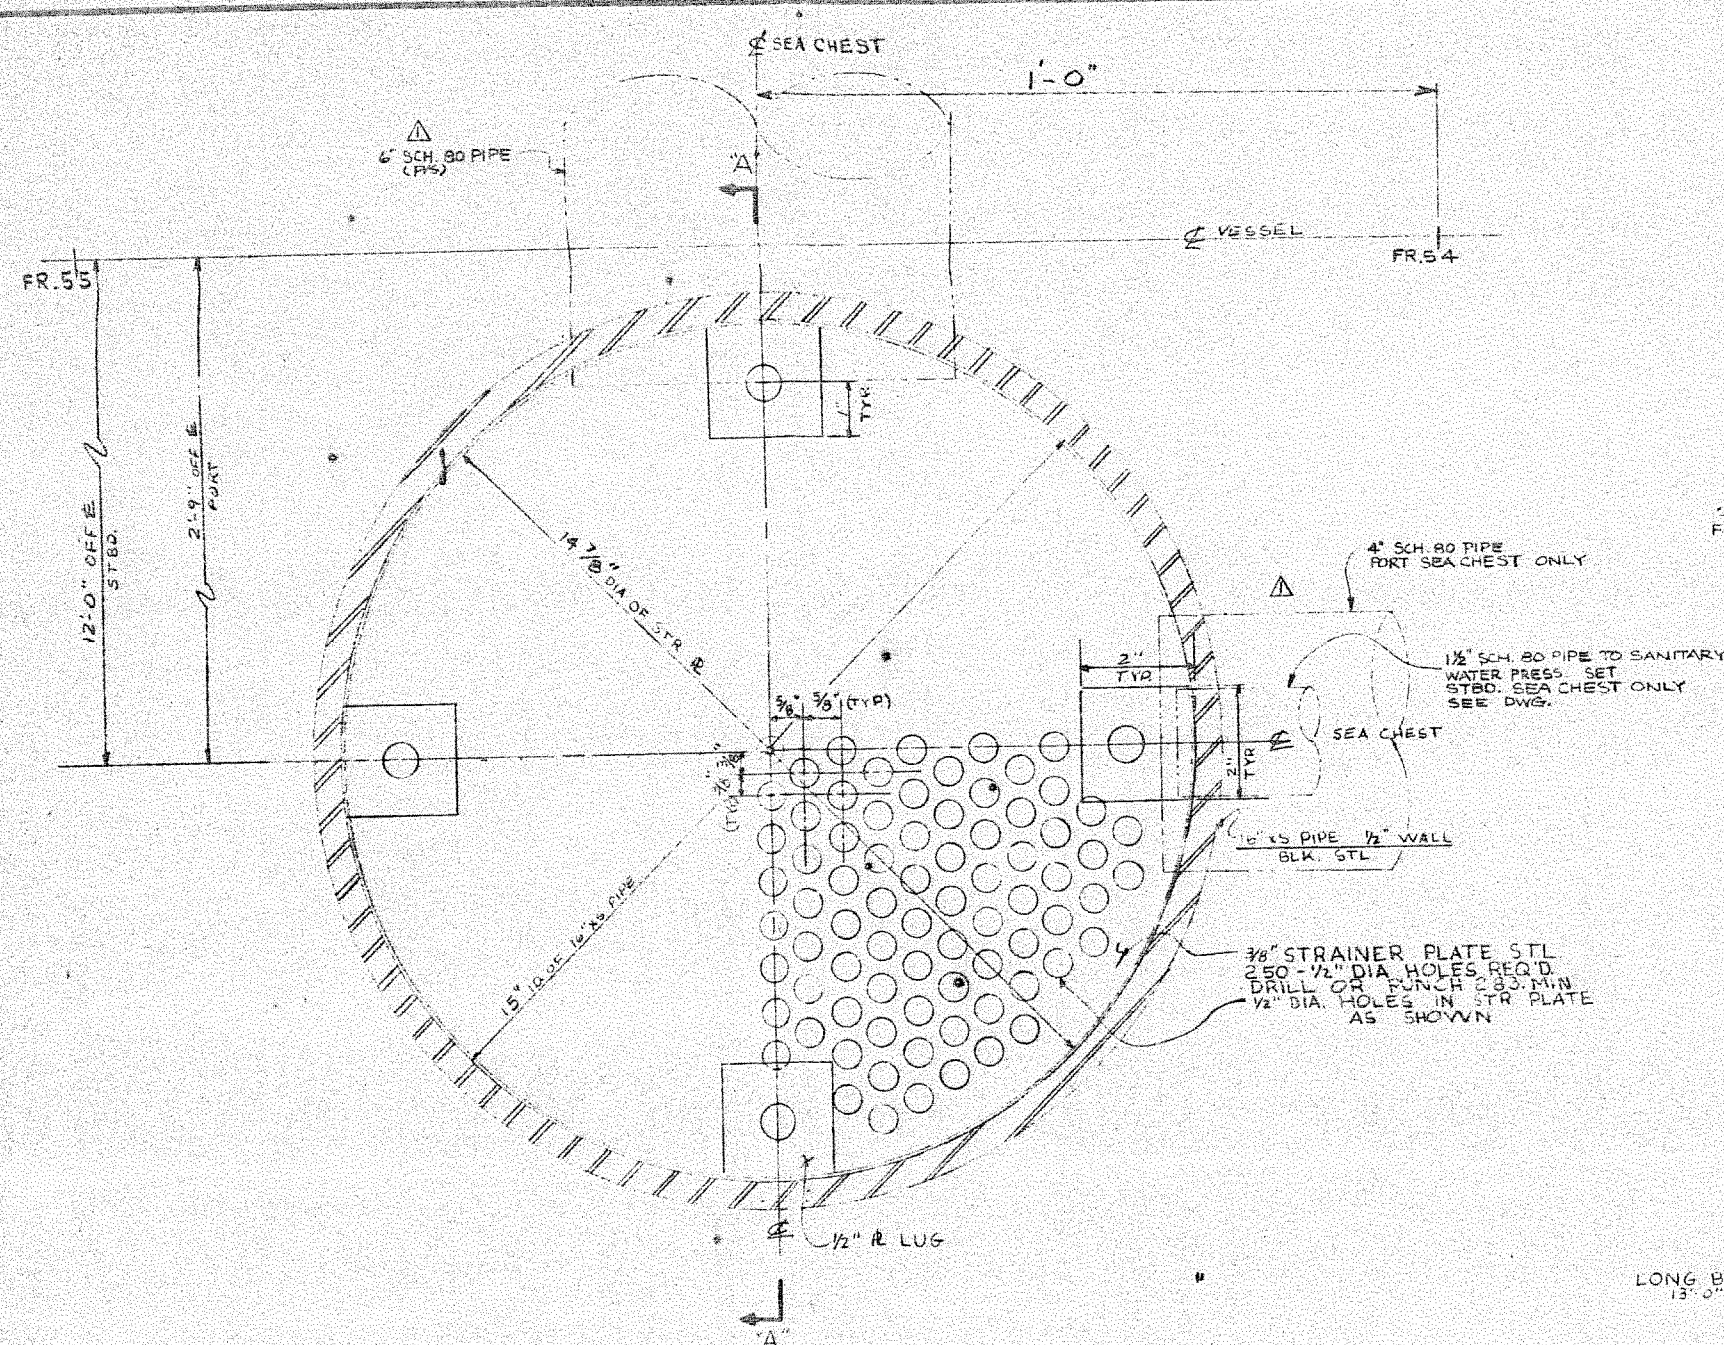

DETAIL 'A'
SEA CHEST STR. PLATE
2 REQ'D 1 STR. PLATE 1 PORT
SCALE: HALF SIZE

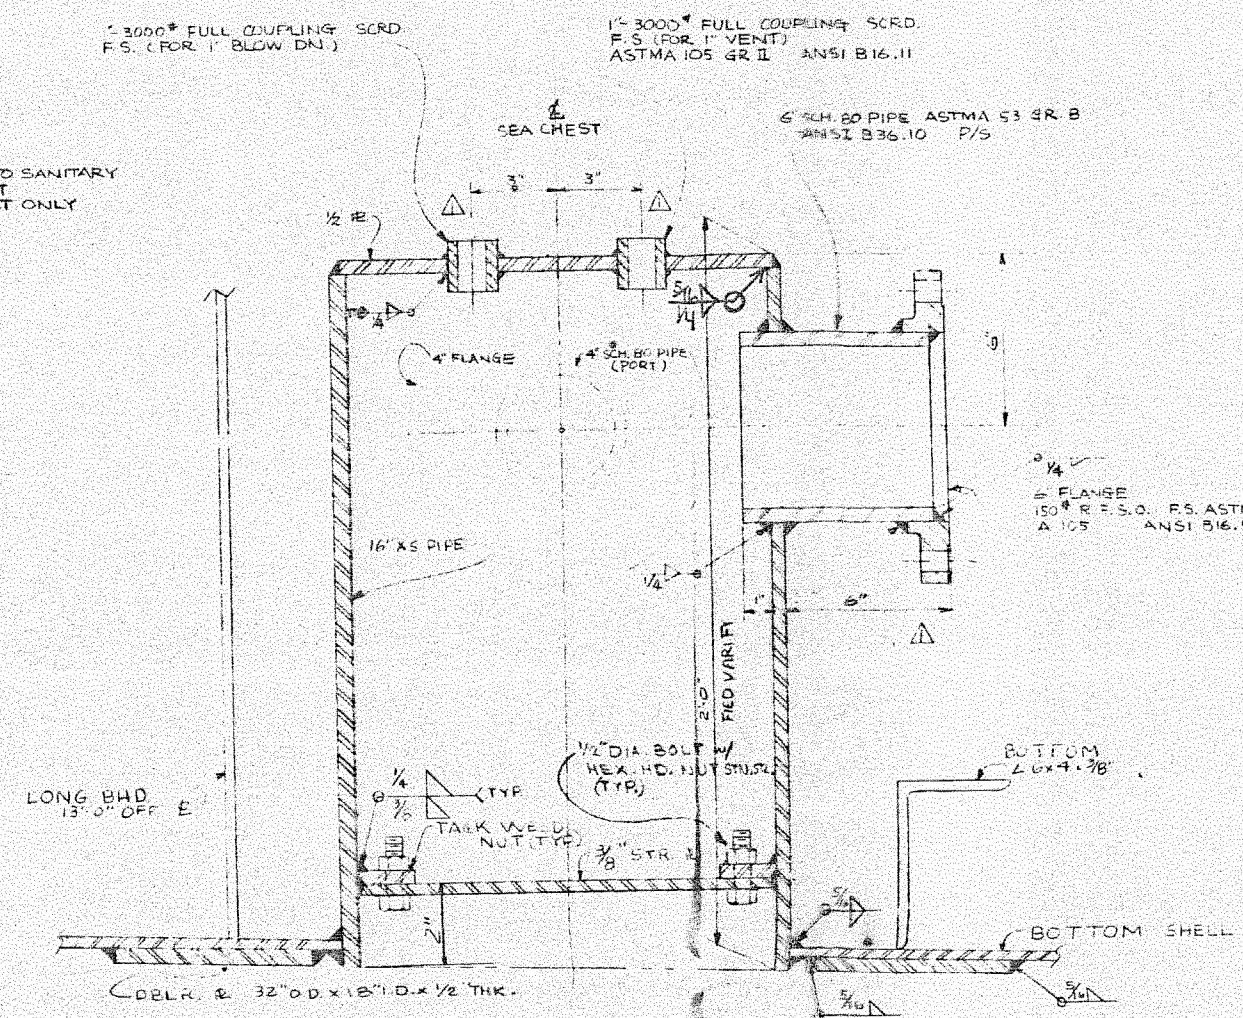

SECTION 'A-A'
SCALE 3\"/>

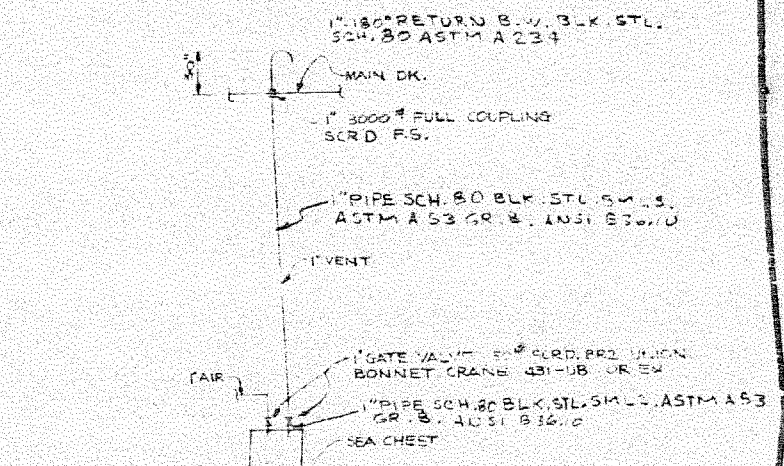

NEW YORK

VENT & AIR BLOW DN. PIPING
FOR SEA CHEST
SCALE: 3\"/>

- NOTES
1. STRAINER PLATES TO BE GALVANIZED AFTER FABRICATION
 2. PROVIDE 2(TWO) ANODES IN EACH SEA CHEST

APPROVED
31 AUG 1981
W. J. HARRIS
V. J. HARRIS



MISS. MARINE TOWBOAT CORP. HULL #90

DESIGN ASSOCIATES, INC.	
NAVAL ARCHITECTS	MARINE ENGINEERS
NEW ORLEANS, LA.	
TIDEWATER MARINE SERVICE	
143'-0" x 36'-0" x 10'-0" SEISMIC VESSEL	
SEA CHEST DET.	
Drawn: BERTUCCI, M.	Date: 6-22-81
Traced:	Date:
Approved:	Date:
Sheet: 1 OF 1	Drawing No. 02062-34

FILE COPY
5 RECEIVED
1 FILE (NEW YORK)
1 FILE (NEW ORLEANS)
1 ABS NEW ORLEANS
0 USCG
INITIALS