



REV. NO.	DESCRIPTION	BY	DATE	APPROVED
1	GENERAL REVISIONS	JS	1-1-61	
2	REVISED FOR TIDEWATER APP. PRINT DATED 1-26-61	JS	1-26-61	
3	REVISED FOR TIDEWATER CLARIFICATIONS ON MARINE PRINT. MAR. 1-27-61	JS	1-27-61	
4	REMOVED RESERVE ON BOW THRUSTER & REV. STRUT TO SUIT	JS	3-1-61	
5	LONG. BULKHEAD AT BOW DECK & REV. STRUTS ED. 12 BY 25	JS	3-1-61	
6	REMOVED ATT. SECTION	JS	3-1-61	
7	ADDED LONG. SECTION CHANGED STEEL BAR REEL THENS ADDED BENTS PER 20 ON LANK. BENTS (2 M. ON 12. 2.5 M. ON 11)	JS	3-1-61	
8	REV. BOW THRUSTER TO INCL. FORWARD THRUSTER & REV. STRUT TO SUIT	JS	3-1-61	
9	MADE CHGS. PER MARKED-UP PRINT. BY DALE GEERDES.	JS		
10	BASED BOW THRUSTER REV. THRUST TUBE (DALE GEERDES.	JS	7-15-61	

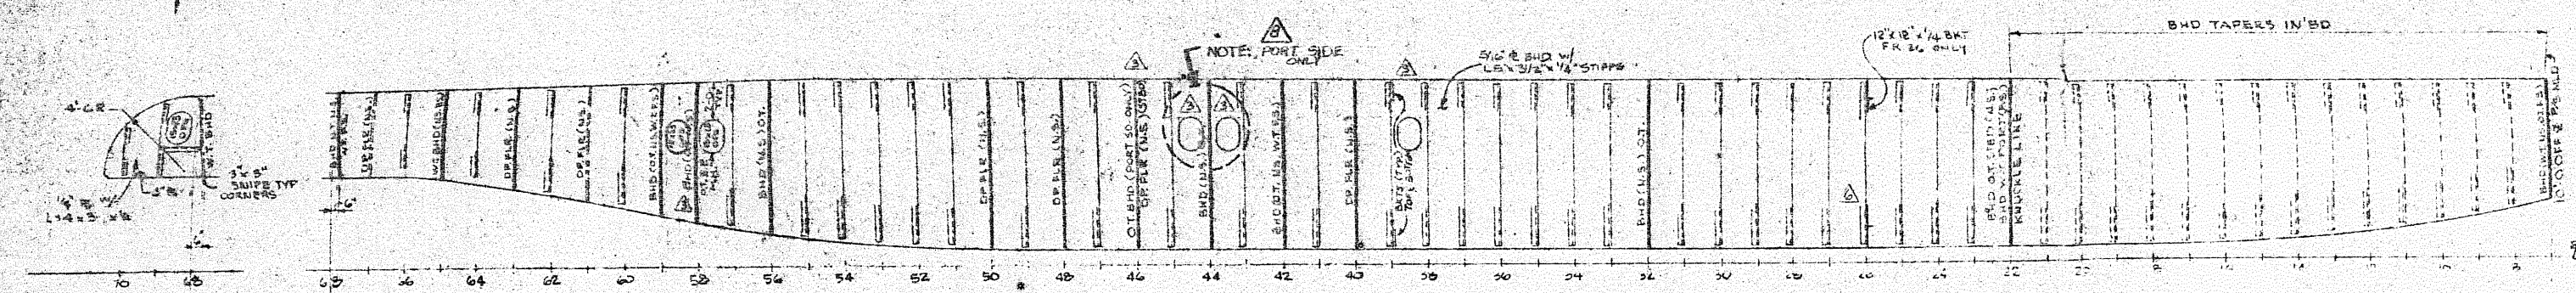


NT. BHD. 2-0
2-0.5-8.3-44.13-0 OFF E


LONG. OI. WT. BHD 13-0 OFF E 2-0 (STBD. SHOWN)
LOOKING INBOARD - PORT OFF HAND

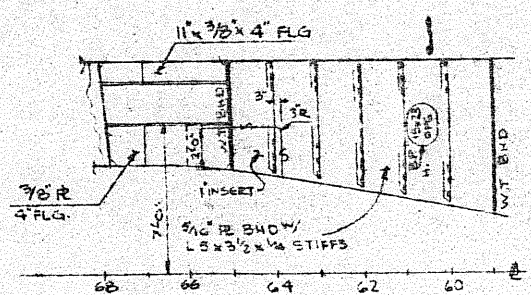


LONG. WT. BHD
2-0 OFF E 2-0 (STBD. SHOWN)
LOOKING INBOARD - PORT OFF HAND

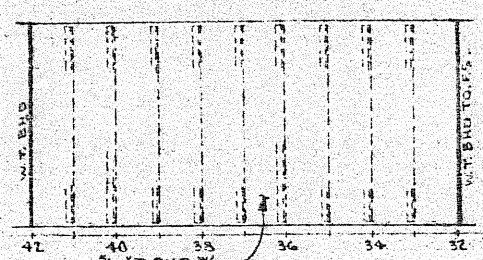


LONG. WT. BHD
8-3 OFF E 2-0 (STBD. SHOWN)
LOOKING INBOARD

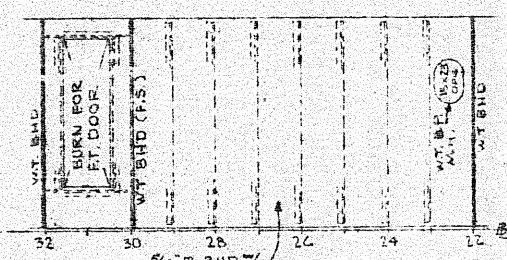


LONG. WT. BHD
2-0 OFF E 2-0 (STBD. SHOWN)
LOOKING INBOARD

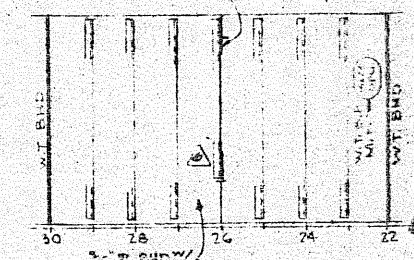


LONG. WT. BHD
2-0 OFF E 2-0 (STBD. SHOWN)
LOOKING INBOARD

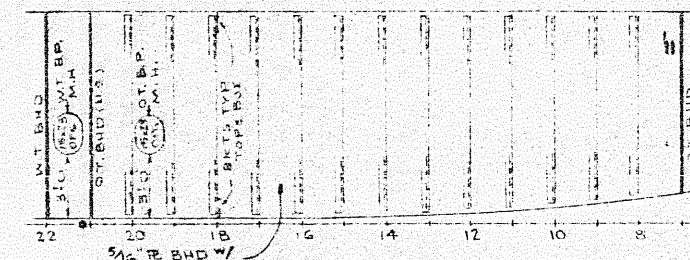


LONG. OI. BHD
4-0 OFF E 2-0 (STBD. SHOWN)
LOOKING INBOARD - PORT OFF HAND

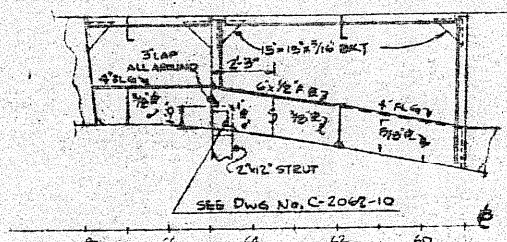

LONG. SECTION 5-0 OFF E
PORT SHOWN LKS. OUTBOARD
STBD. OFF HAND

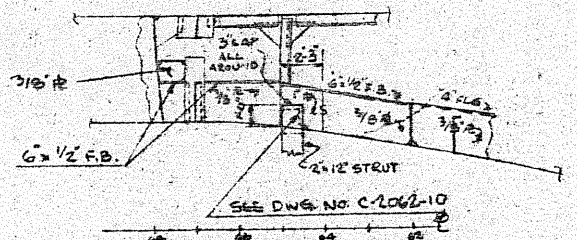

LONG. SECTION 9-4 OFF E
PORT SHOWN LKS. OUTBOARD
STBD. OFF HAND

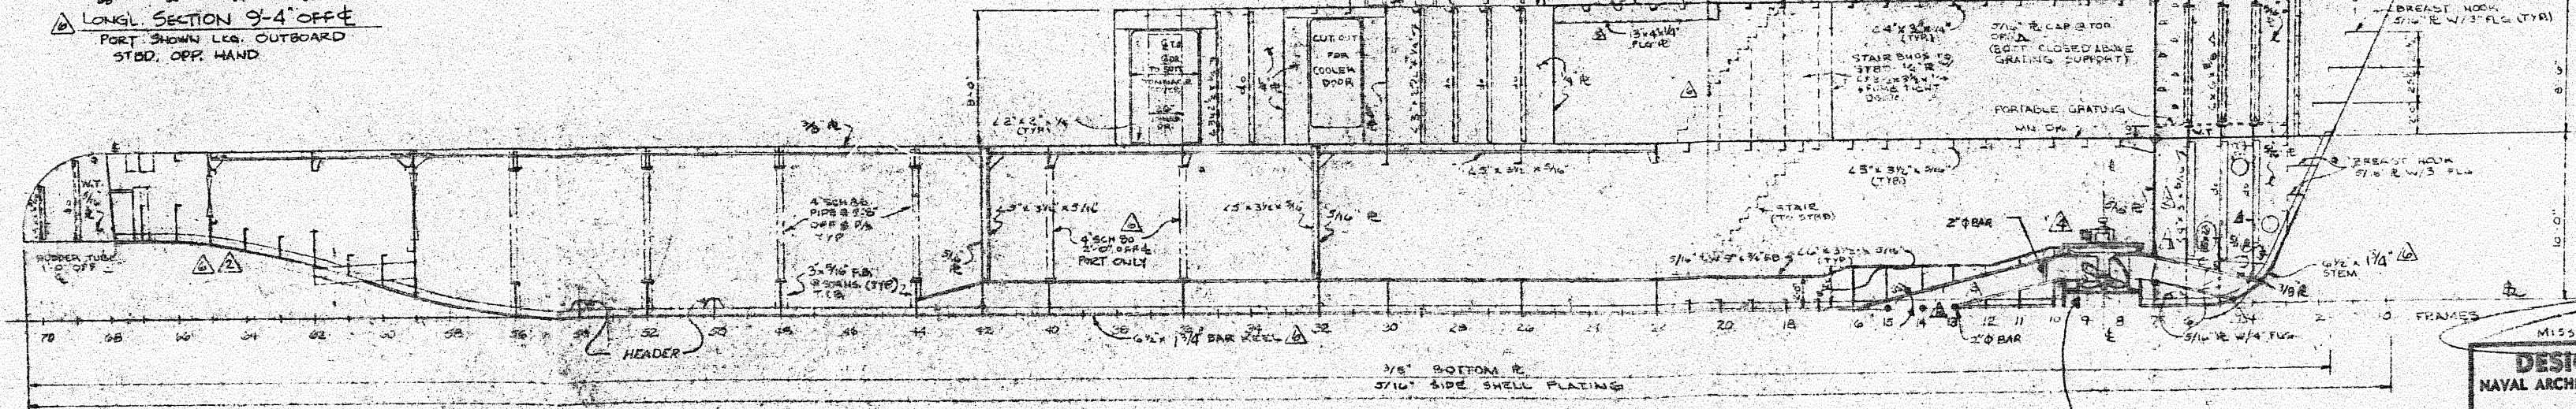

NEW YORK

RE-SUBMISSION

APPROVED
31 AUG 1981
W. H. HANNA
P. J. STOKES



MISS. MARINE TOWNSHIP CORP. #90

DESIGN ASSOCIATES, INC.
NAVAL ARCHITECTS
NEW ORLEANS, LA.
MARINE ENGINEERS

TIDEWATER MARINE SERVICE

143' x 36' x 10' SEISMIC VESSEL

CONSTRUCTION PROFILE
LONGITUDINAL BULKHEADS

Drawn: B. HANNA Date: 11/22/60 Checked: A.L.S.
Traced: Date: Checked:
Agreed: Date: Checked:
Sheet 1 of 1 Drawing No. C-2042-3 Revision Mark

FILE COPY

5 RECEIVED

FILE (NEW YORK)

FILE (NEW ORLEANS)

ASSN. NEW ORLEANS

USCG

ULM INITIALS