
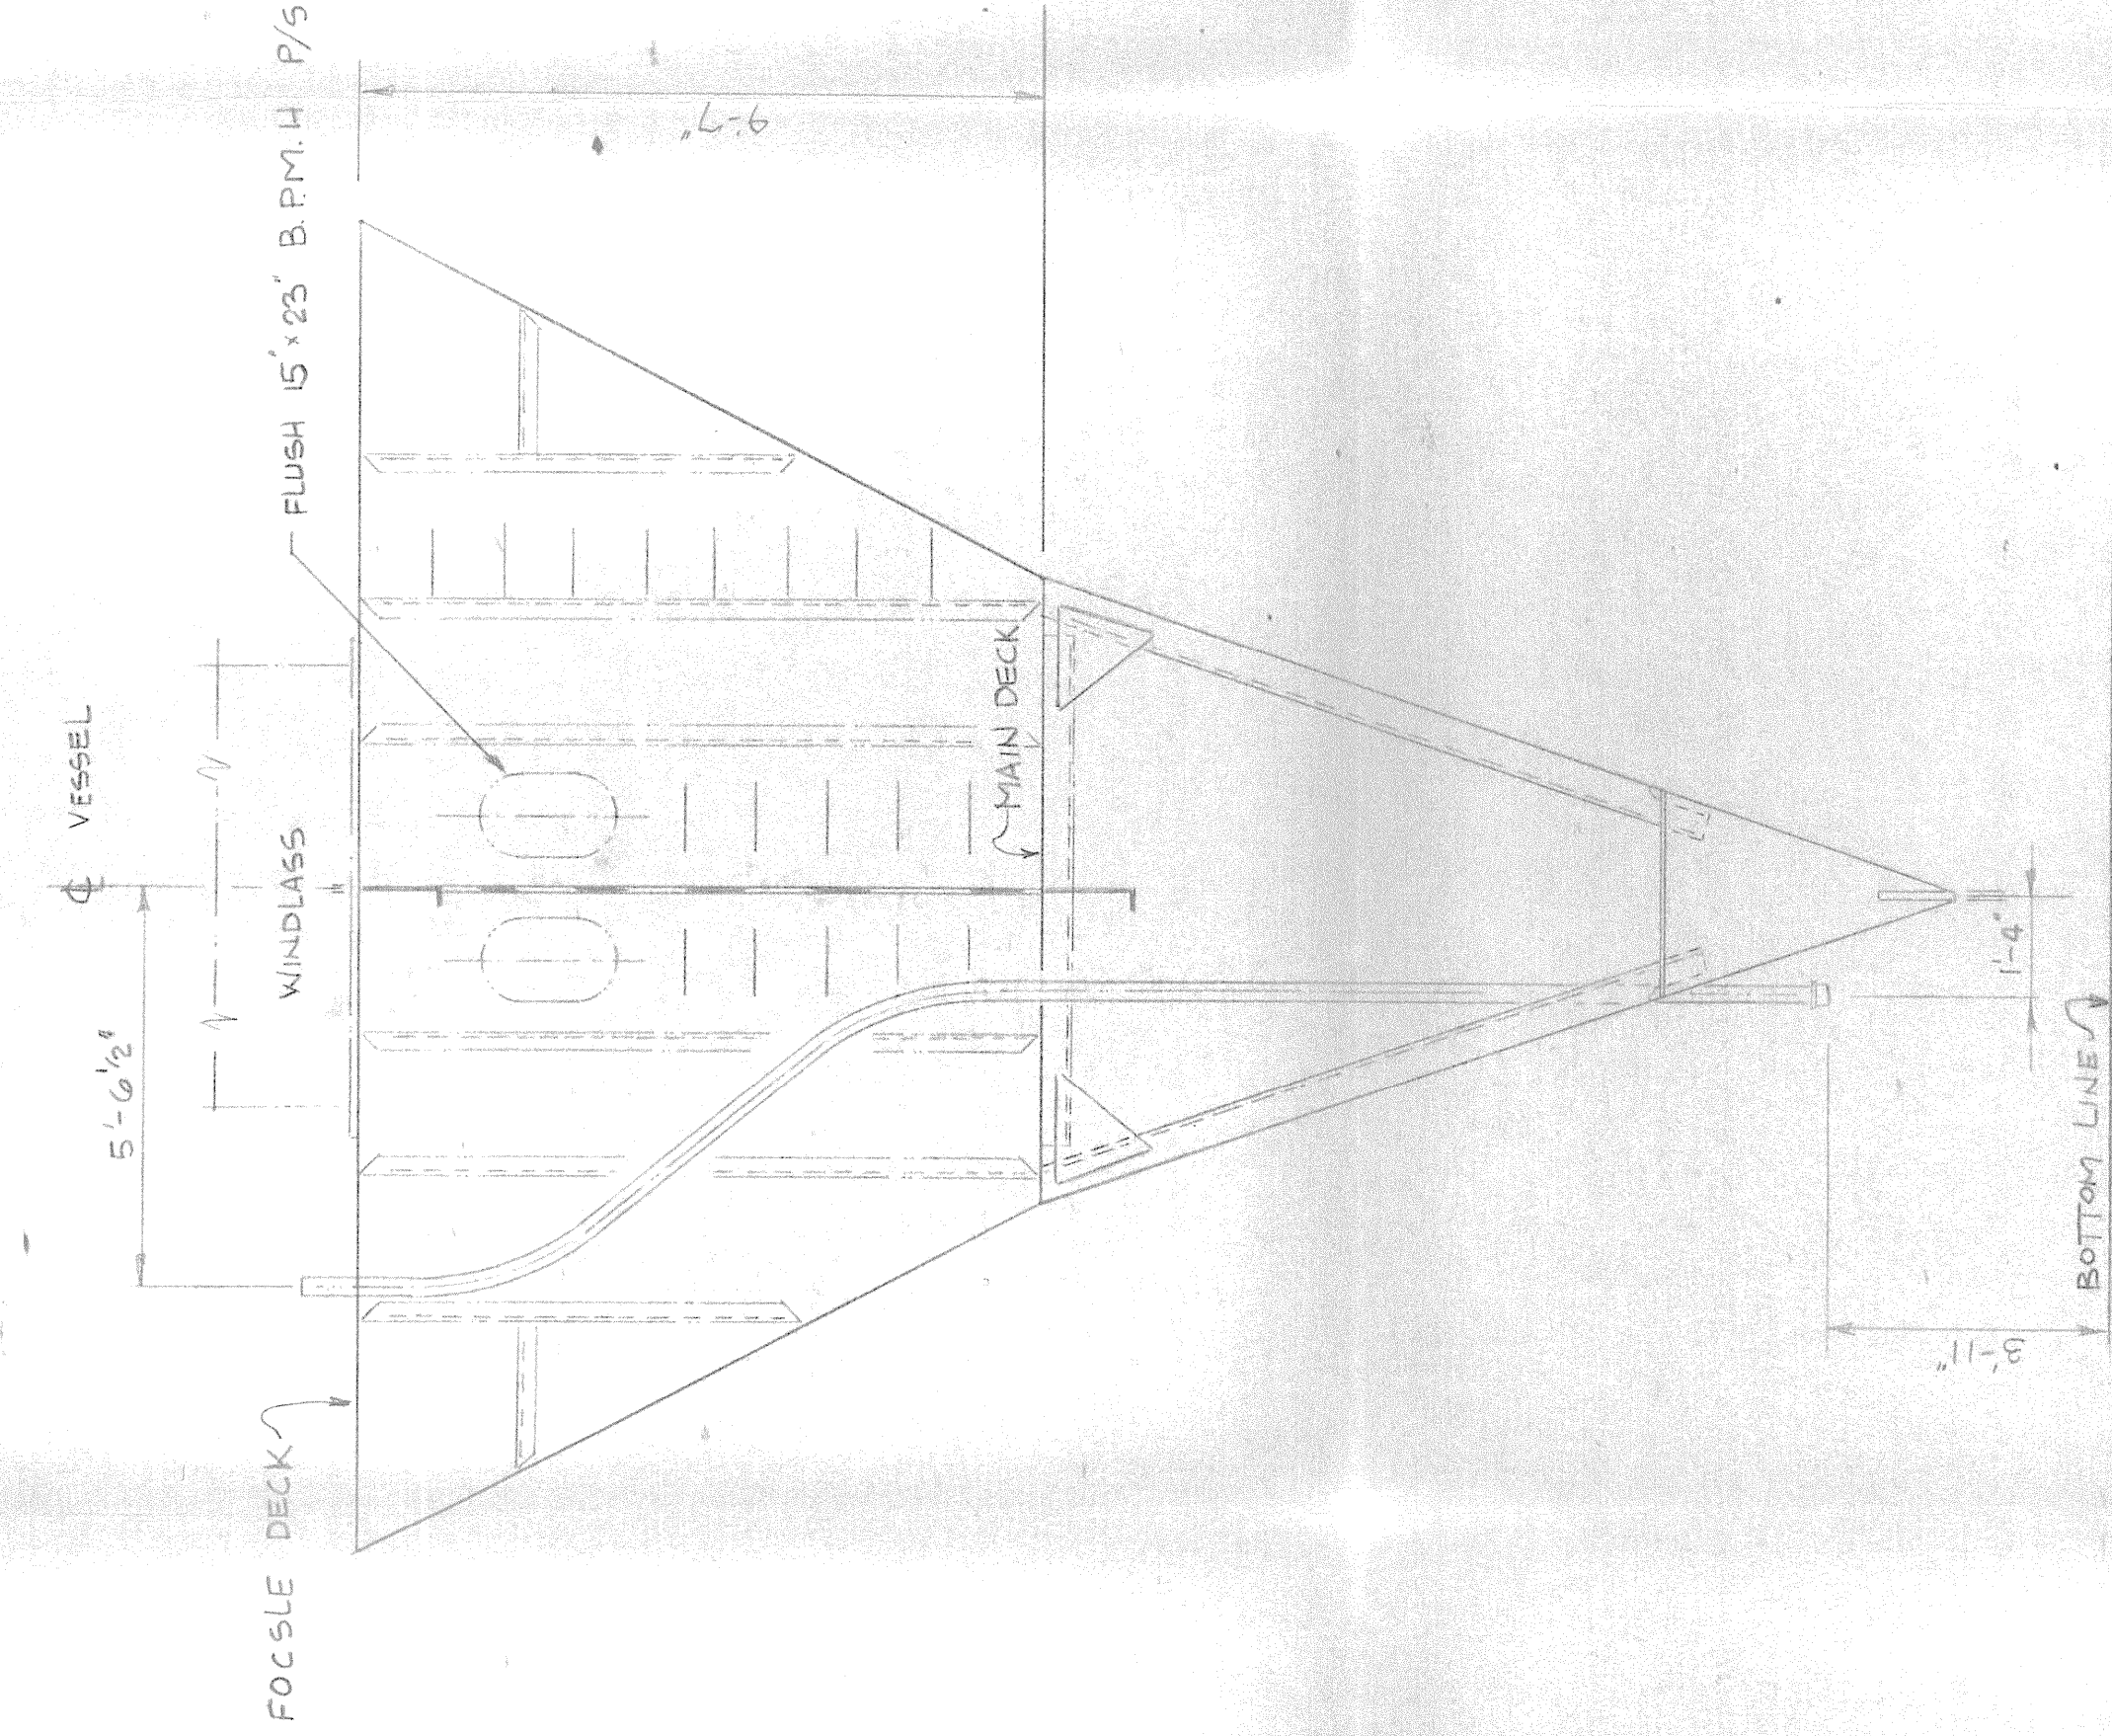



[illegible]

SECTION 3-B Δ

SECTION 2-A
 $\frac{3}{16}$ = 1 Foot

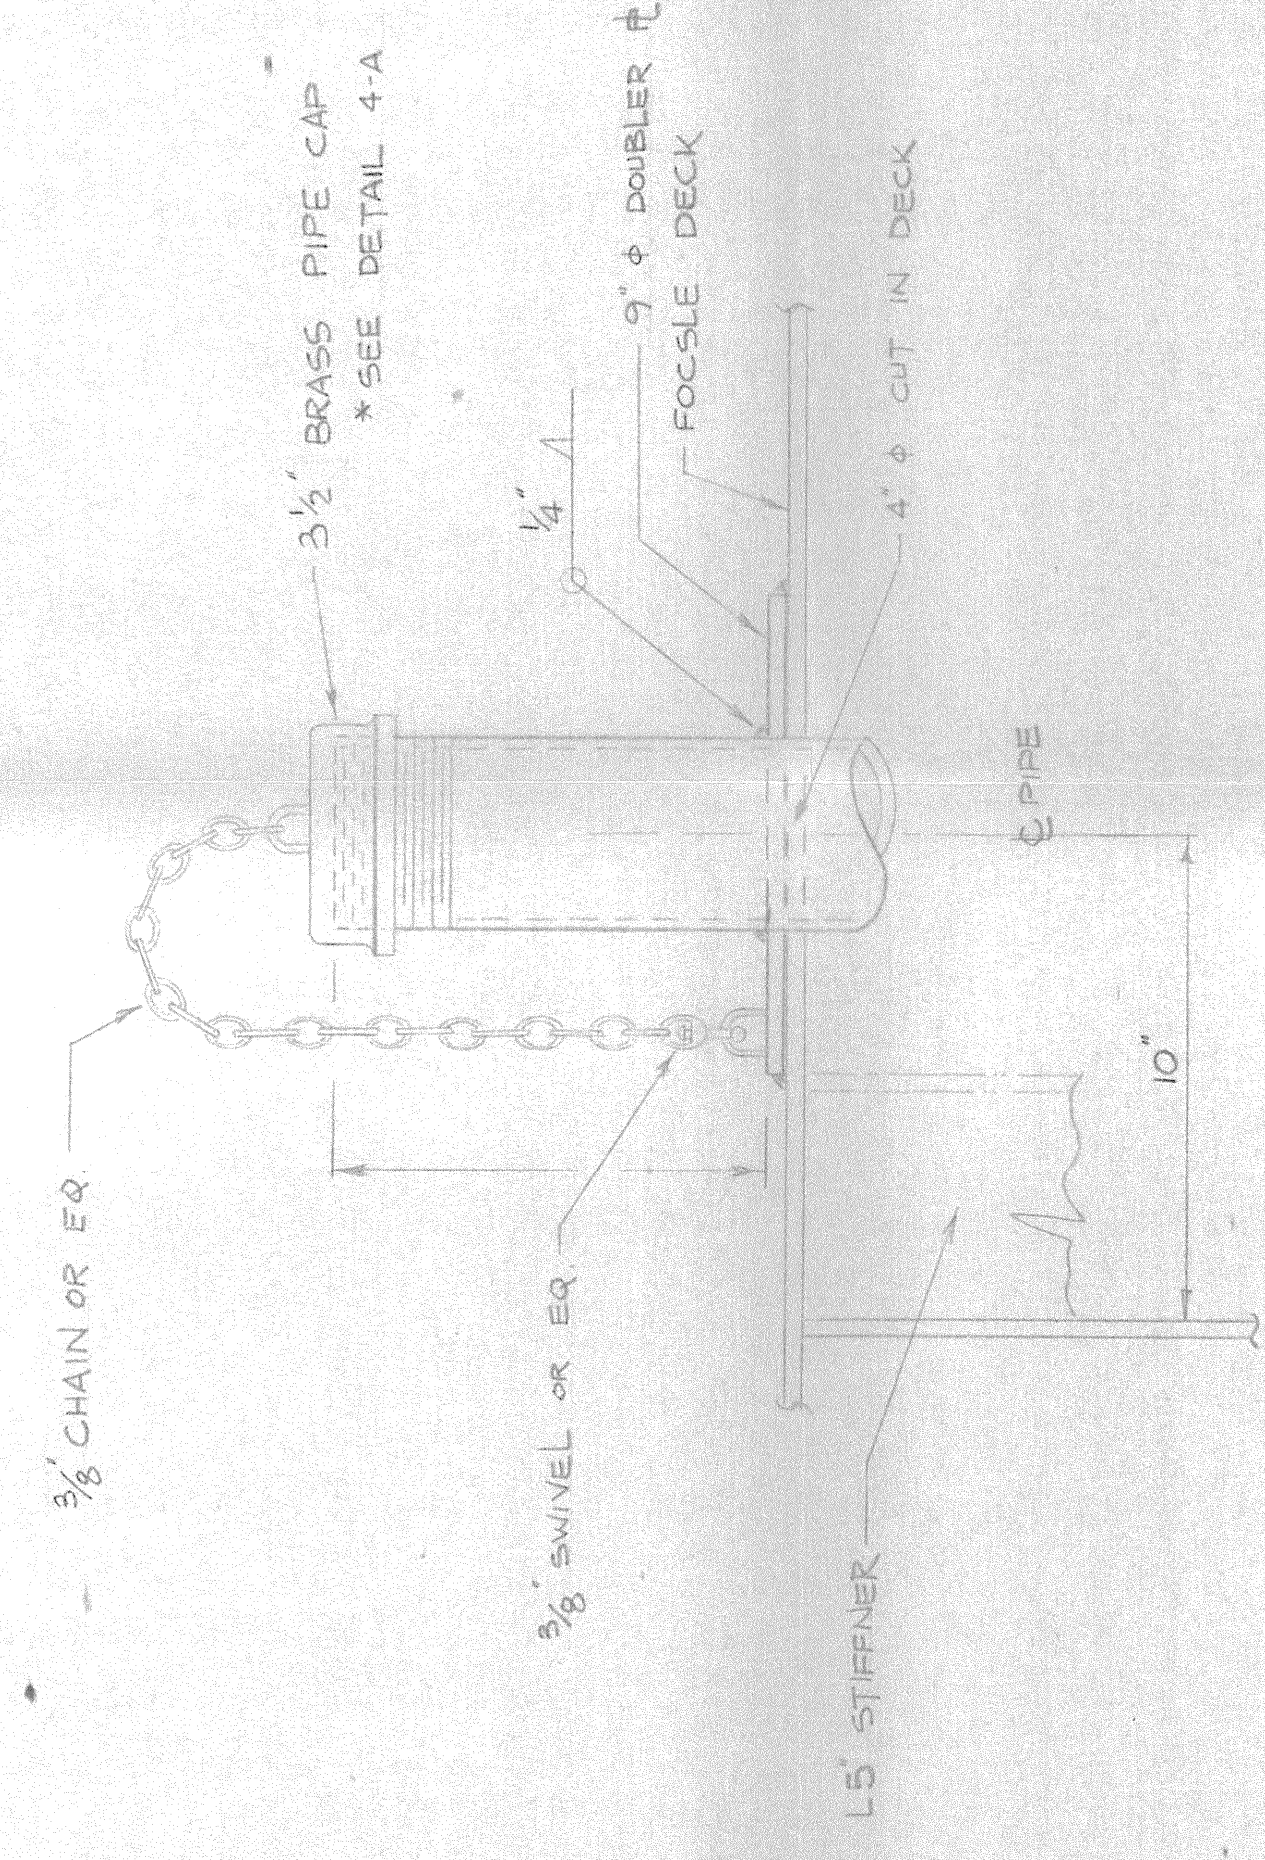

SECTION 4-B

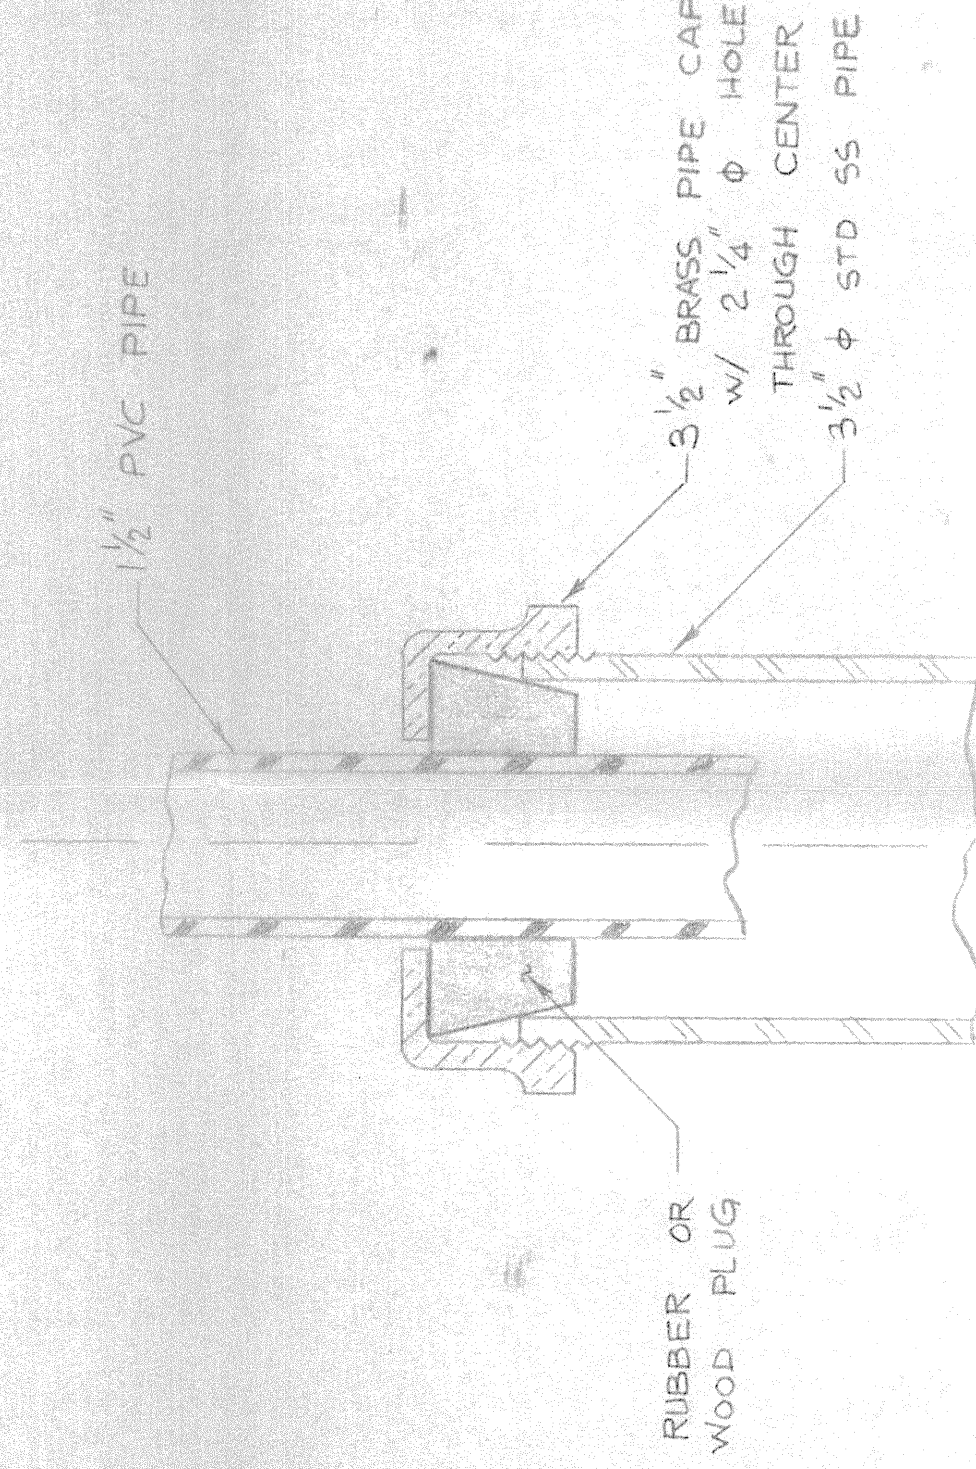

DETAIL 4-A
— HALF SIZE —
(IN SERVICE CONNECTION)