


MARK	ALTERATIONS	DESCRIPTION	DATE APP.
Δ	REMOVED PORTLIGHTS & ADDED TOILET PER MEETING OF 6/26/11		
Δ	ADDED WELDING DETAILS		7/1/11
Δ	ADDED A B.S. APPROVAL ALTERED TO AS BUILT		

SWG. NO.	TITLE
1501-2	FGC'S DECK HOUSE ADDITIONS
1501-2	DECK HOUSE ADDITIONS

REFERENCE PLANS

GENERAL NOTES
1. ALL WORK & WELDING TO BE IN ACCORDANCE WITH A.B.S. RULES & REGULATIONS.
2. REF. 1501-2 FOR TONNAGE OPENING DETAILS

MAY 01 1980
172 X 36 X 15 MW GYRE
AGOR-21
HALTER MARINE HULL-375

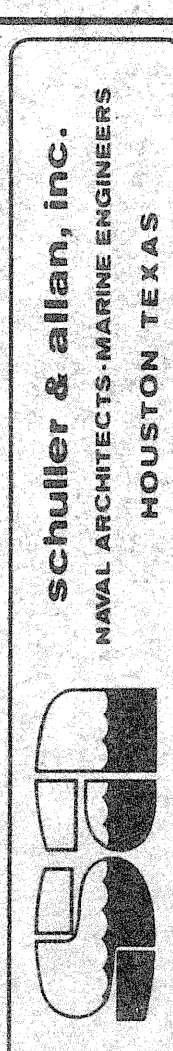

OCEAN RESEARCH VESSEL GYRE	TITLE
DECK HOUSE ADDITIONS	CHECKED
	DATE
	APPROVED
SCALE 3/8" = 1'-0" DWG. NO. 1501-TSHT.2	ALT. 1/5

APPROVED BY A.B.S. LET
DATED JAN 28, 1980

00082

