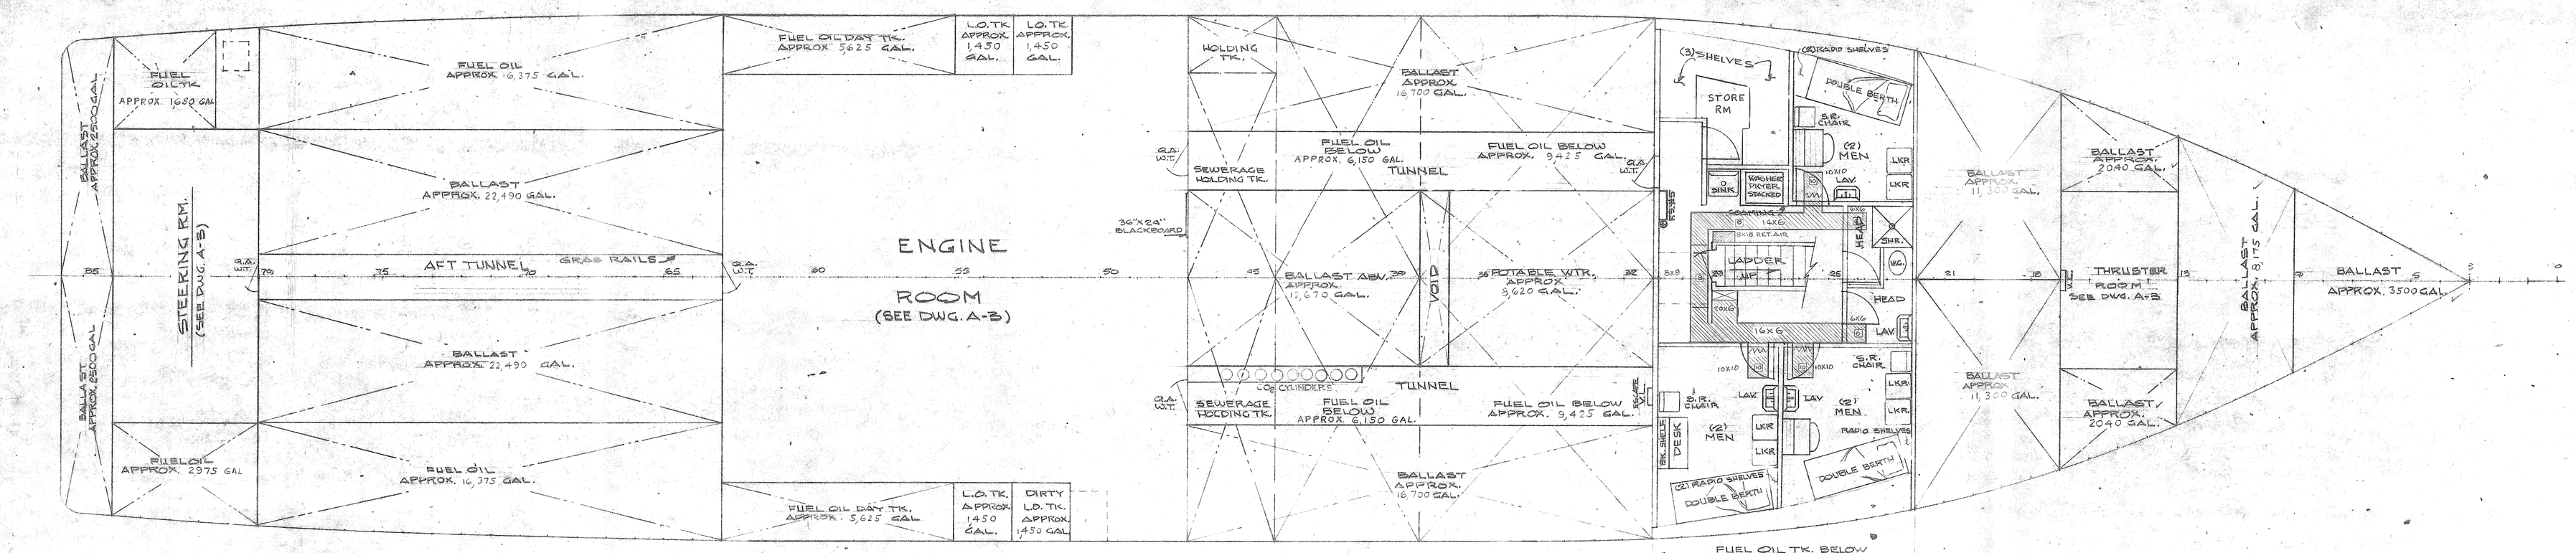

HOLD PLAN

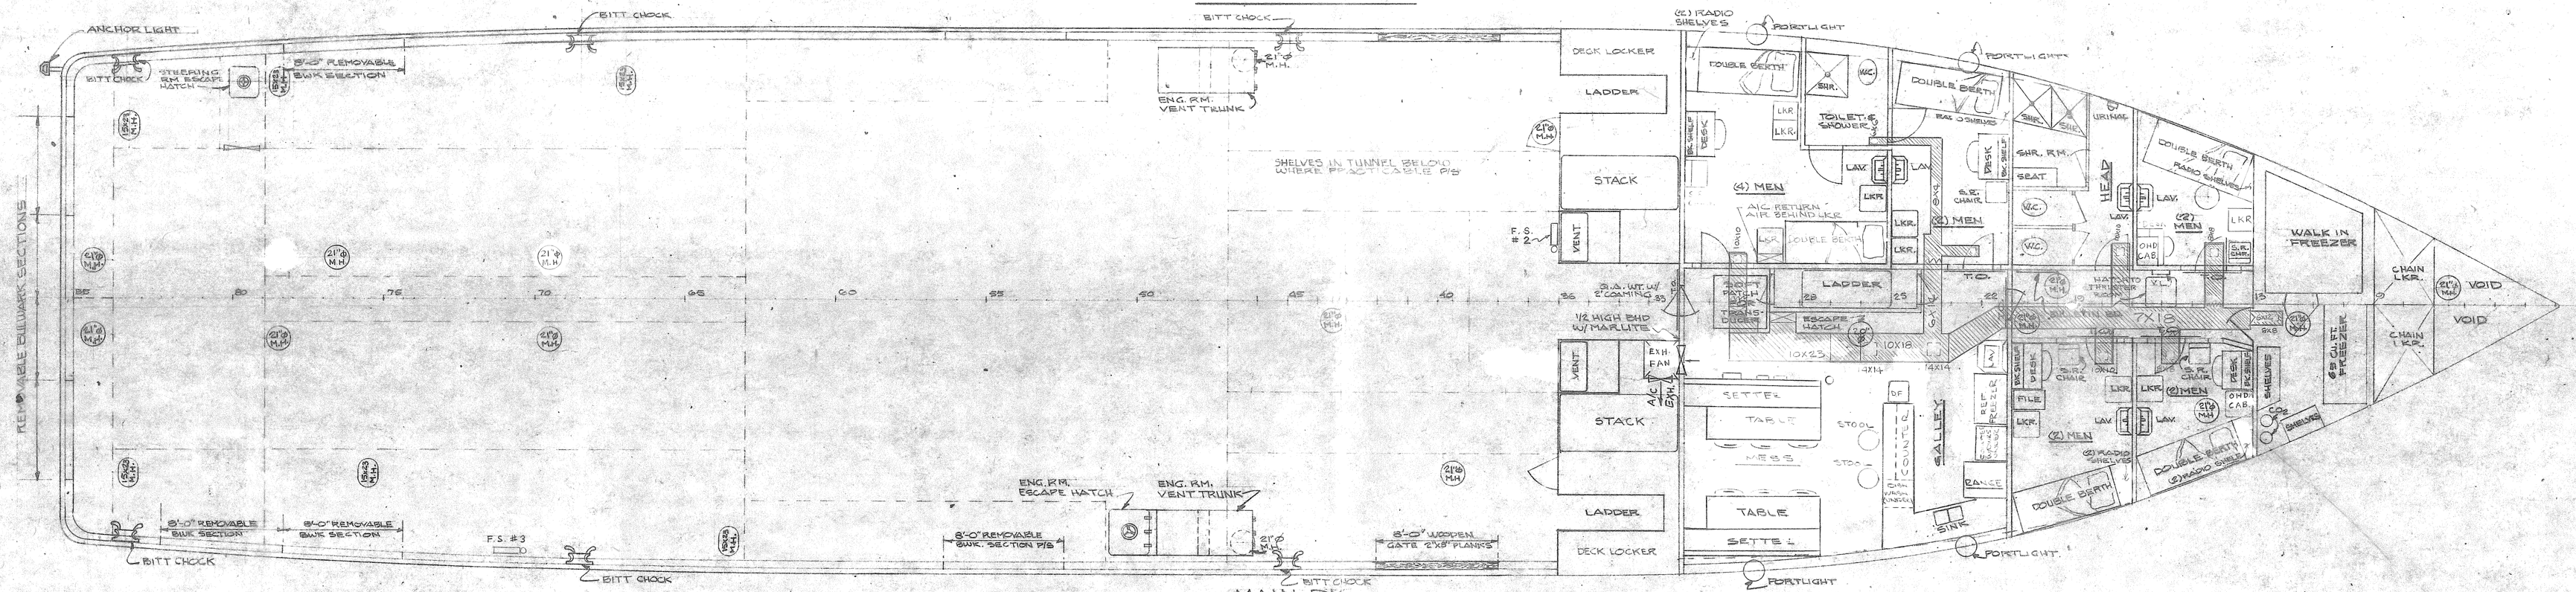

MAIN DK.

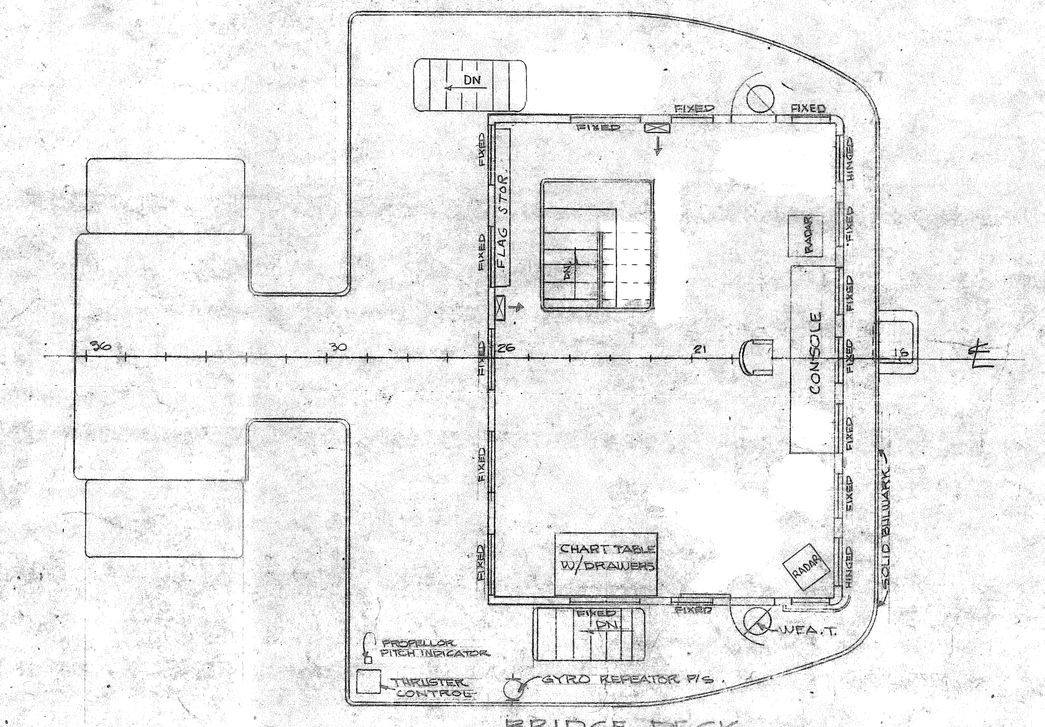

BRIDGE DECK

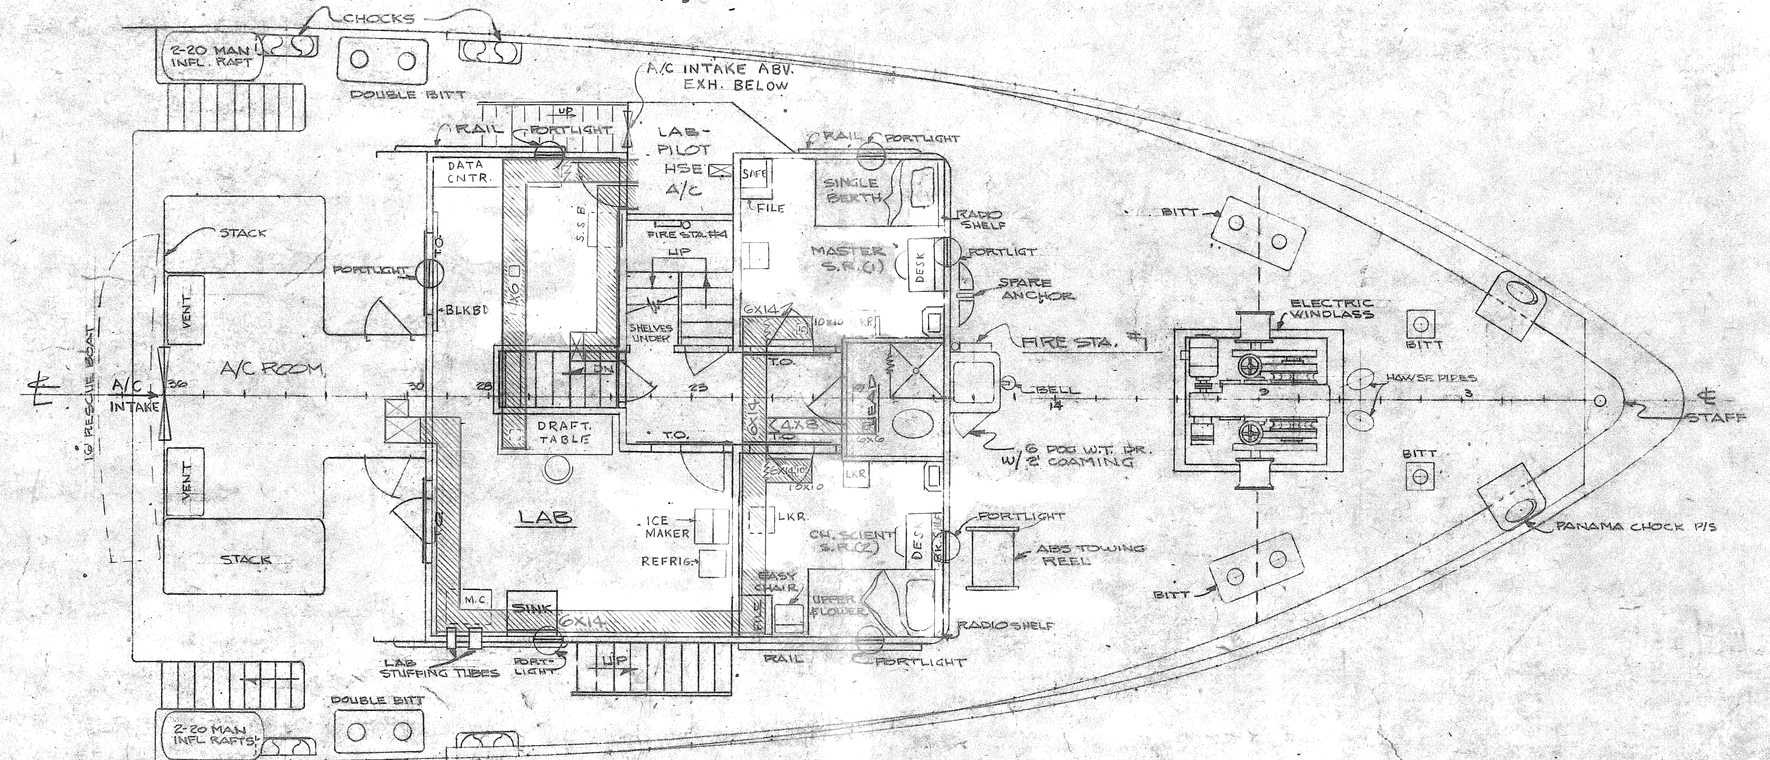

FOCSLE DK.

2	AS BUILT	11/14/73	CJR
1	REV. INDICATION OF ARRGT. IN MESS & GALLEY	6/15/73	JW
SYM	DESCRIPTION	DATE	BY

REVISIONS

APPROVALS

ABS
USCG
USPHS

OFFICE COPY

U.S. NAVAL SHIP SYSTEMS COMMAND
WASHINGTON D.C. 20360

OCEANOGRAPHIC RESEARCH SHIP
AGOR (UTILITY) CLASS

HALTER MARINE SERVICES, INC.
P.O. BOX 29266 NEW ORLEANS, LA. 70129

A/C DUCT ARRANGEMENT

SCALE-	3/16"=1'-0"	DATE	11 JUNE '73	HALTER DWG. NO.
DRAWN BY-		CK'D BY		A-7
HALTER HULL NO.	375 376	HALTER JOB NO.	2187 2188	
NAVSHIPS NO.	AGOR 21-501-502			REV. 2

00007

GYRE001